

Approved  
Bd of Appeals  
May 13, 1974

APPROVED  
MADISON TWP. ZONING  
Permit: 9083  
Zoning Inspector: *R. D. [Signature]*

# SITE PLAN

MADISON

LAKE COUNTY, OHIO

TOWNSHIP

for: DEBEVEC  
CLIENT OWNER

ADDRESS STREET CITY ZIP

Northern Lights Subd.  
SUBDIVISION S-58 NAME  
# 58 VOL - PG  
SUBLOT NO. East Tuttle Rd STREET

LOT TRACT  
VOLUME PAGE  
PERM. PARCEL # STREET

## LEGEND

- SANITARY MANHOLE
- STORM MANHOLE
- INLET OR CATCH BASIN
- HYDRANT
- EXISTING CONTOURS
- PROPOSED CONTOURS
- EXIST. ELEV.  $\pm 100.0$
- PROP. ELEV.  $\pm 100.0$
- WATER VALVE (GAS)
- WATER METER (GAS)
- AS BUILT ELEVATION
- INDICATES DIRECTION OF SURFACE DRAINAGE

## REMARKS

ALL BOUNDARY DATA SHOWN WAS OBTAINED FROM (DEEDS, RECORDED SUBDIVISION PLAT OR OTHER PUBLIC RECORDS)

## DESIGN CERTIFICATION

THIS PLAT WAS PREPARED BY ME, AND IS CORRECT TO THE BEST OF MY KNOWLEDGE AND BELIEF.

*Richard [Signature]* PS #5244  
NAME SURVEYOR REGISTRATION NO.

## CHECK LIST

- |                               |                                |
|-------------------------------|--------------------------------|
| DIMENSIONS                    | WATER MAIN SIZE LOCATION       |
| BEARINGS                      | SAN SEWER SIZE % GR. LOC.      |
| TIE TO NEAREST STREET         | SAN. MH CAST ELEV. INV. ELEV.  |
| SUBLOT NO. PARCEL NO.         | SAN. CONN. SIZE LOC. DEPTH     |
| SURROUNDING OWNERS            | STORM SEWER SIZE % GR. LOC.    |
| BLDG DIMENSIONS FIN. GR.      | STORM MH CAST ELEV. INV. ELEV. |
| BLDG TIES FLR GRADES          | PAVT TYPE GRADE CURBS          |
| APRON TYPE WIDTH THICKNESS    | GAS LINE LOC. SIZE PRESSURE    |
| SIDEWALK TYPE WIDTH THICKNESS | SEPTIC TANK SIZE LOC.          |
| CULVERT TYPE DIA. LENGTH      | WELL LOCATION                  |

## REVISIONS

NO	DATE	BY
1		
2		
3		
4		
5		

## PLAN PREPARED BY:


DEBEVEC SALO & ASSOC, INC.  
130 EAST JACKSON ST. PAINESVILLE

DRAWN BY *[Signature]* SCALE  $1" = 30'$  PHONE NO.  
CHKD *[Signature]* DATE 4/25/74 DRAWING NO.  
CREW CHIEF APPD *[Signature]* 4146-58



Grading Plan Approved  
as shown and/or noted  
THOMAS P. GILLES, P.E.  
Lake County Engineer

By *JWK* Date 5-14-74

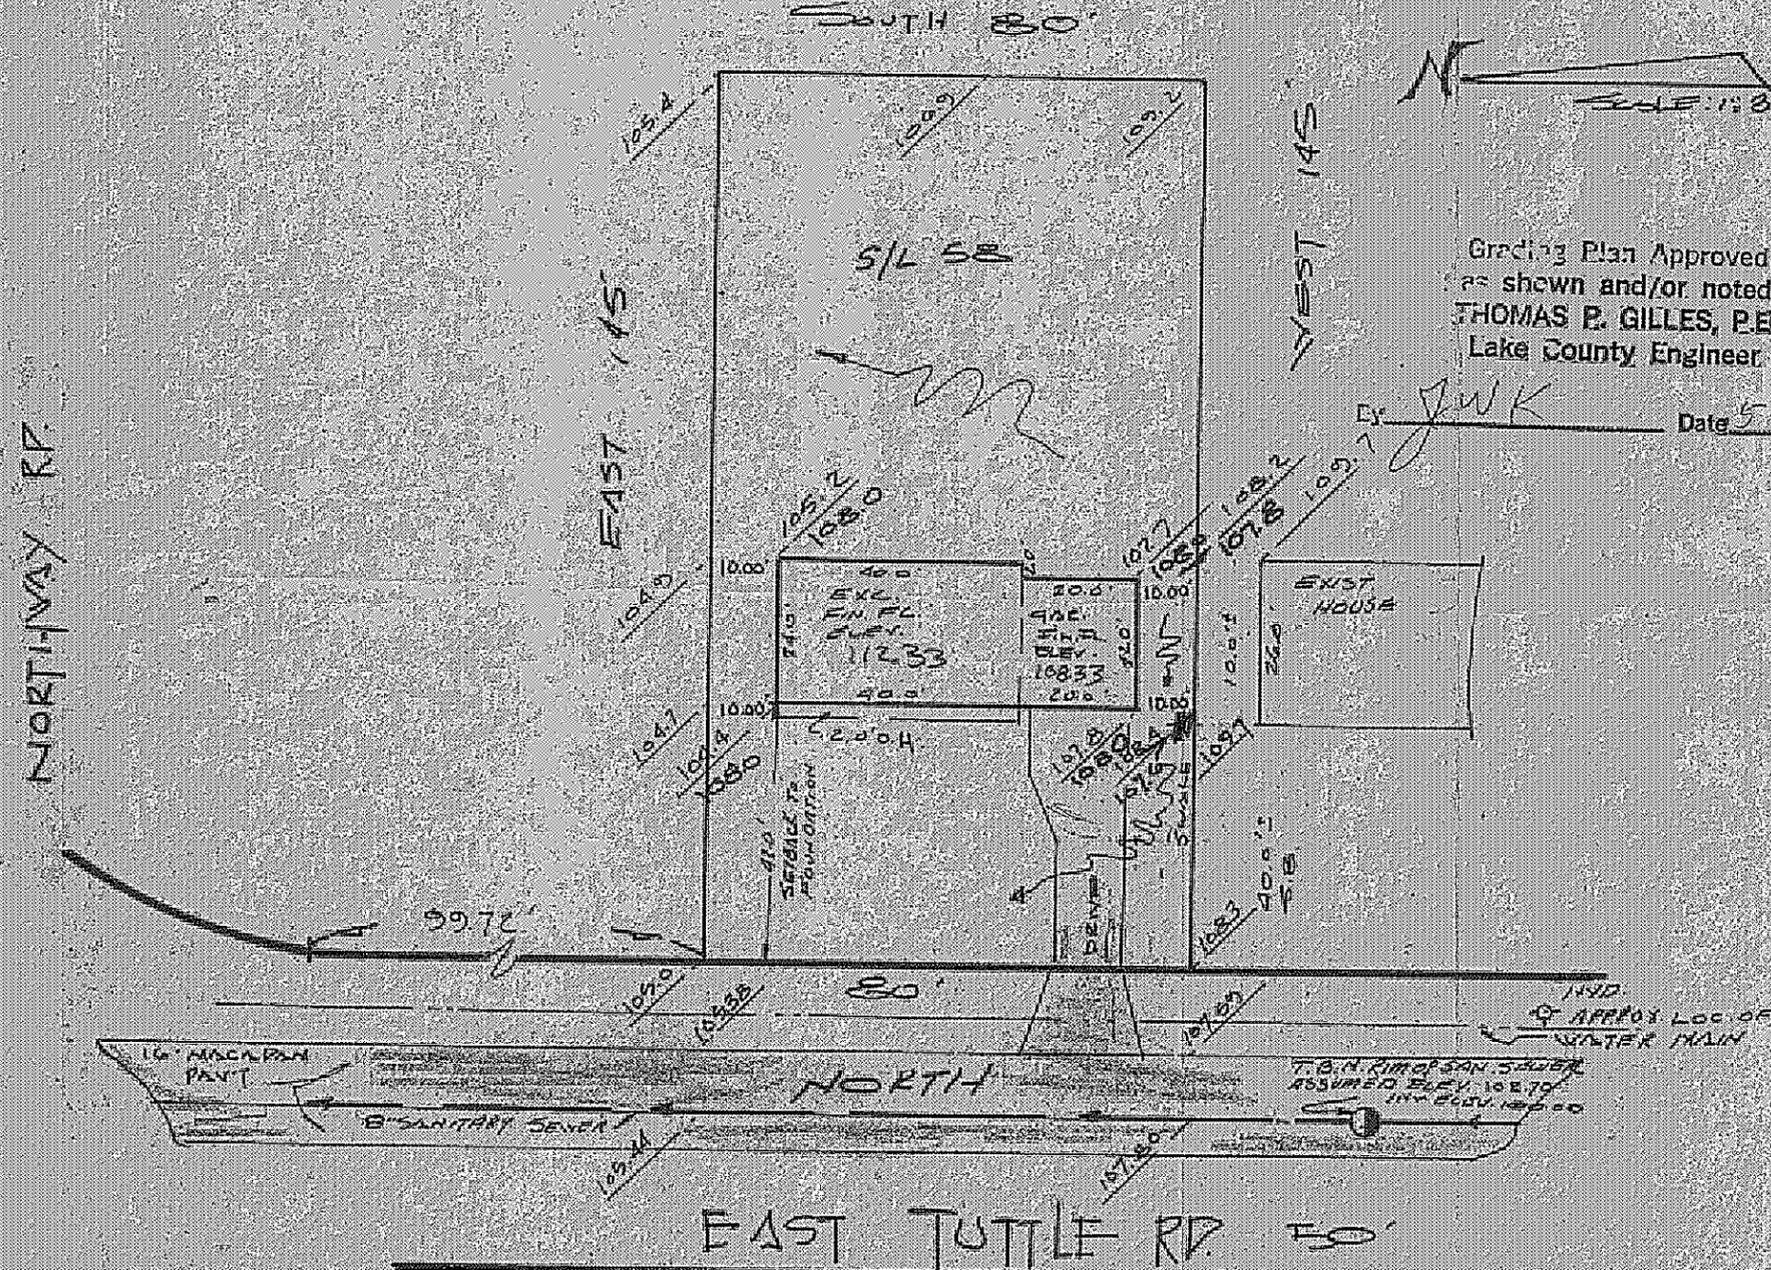

## "AS BUILT" CERTIFICATION

I, HEREBY CERTIFY THAT THE CIRCLED GRADES ARE EXISTING FINISH GRADES CHECKED IN FIELD ON \_\_\_\_\_ 19 \_\_\_\_ BY SURVEYING AND ARE CORRECT TO THE BEST OF MY KNOWLEDGE AND BELIEF

REGISTERED SURVEYOR \_\_\_\_\_ REG. NO. \_\_\_\_\_